
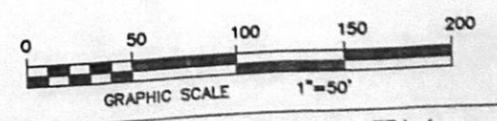


AR. HIGHWAY No. 226  
(WOODSPRINGS Rd)

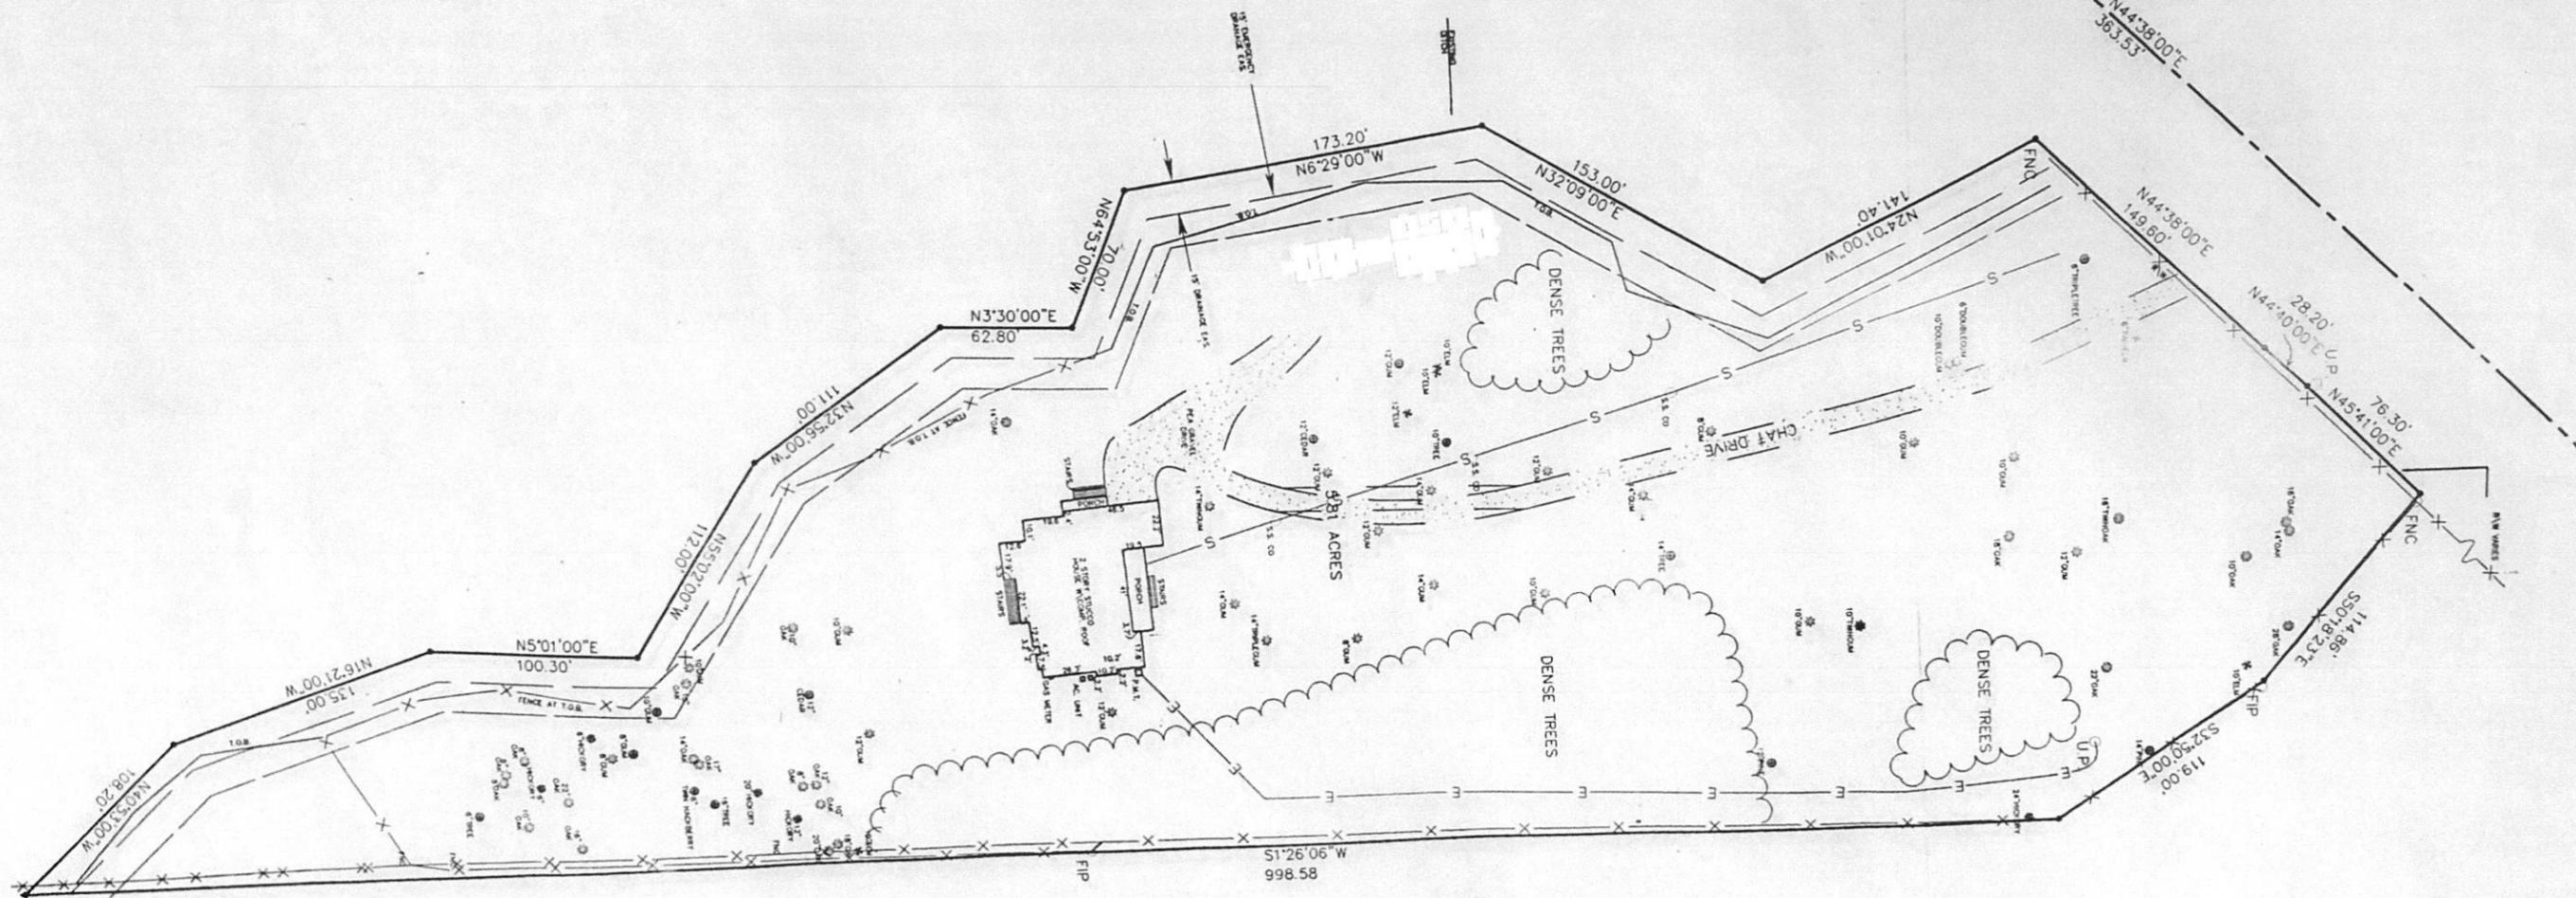

CLIENT: <b>GREG HAAG</b>		<b>AS BUILT SURVEY</b>		REVISIONS <small>DATE BY DESCRIPTION</small>	
		GREG HAAG'S WOODSPRINGS ROAD ADDITION TO JONESBORO CRAIGHEAD COUNTY, ARKANSAS		<small>CHECKED BY:</small> B. STACY	<small>CHECKED BY:</small> B. STACY
CLIENT: <b>GREG HAAG</b>		HAYWOOD, KENWARD, BARE & ASSOCIATES, INC. CIVIL ENGINEERING - SURVEYING - PLANNING 3301 E. HIGHLAND DRIVE JONESBORO, ARKANSAS 72401 <small>TEL 870-932-2019 FAX 870-932-1078</small>		<small>DATE:</small> 9/23/98	<small>SCALE:</small> 1"=50' <small>DRAWING NO.:</small> 300172